

NW

North of
Tanquary Pass

Structural High
Tanquary ~~Uplift~~

Head of
Tanquary Fiord

SE

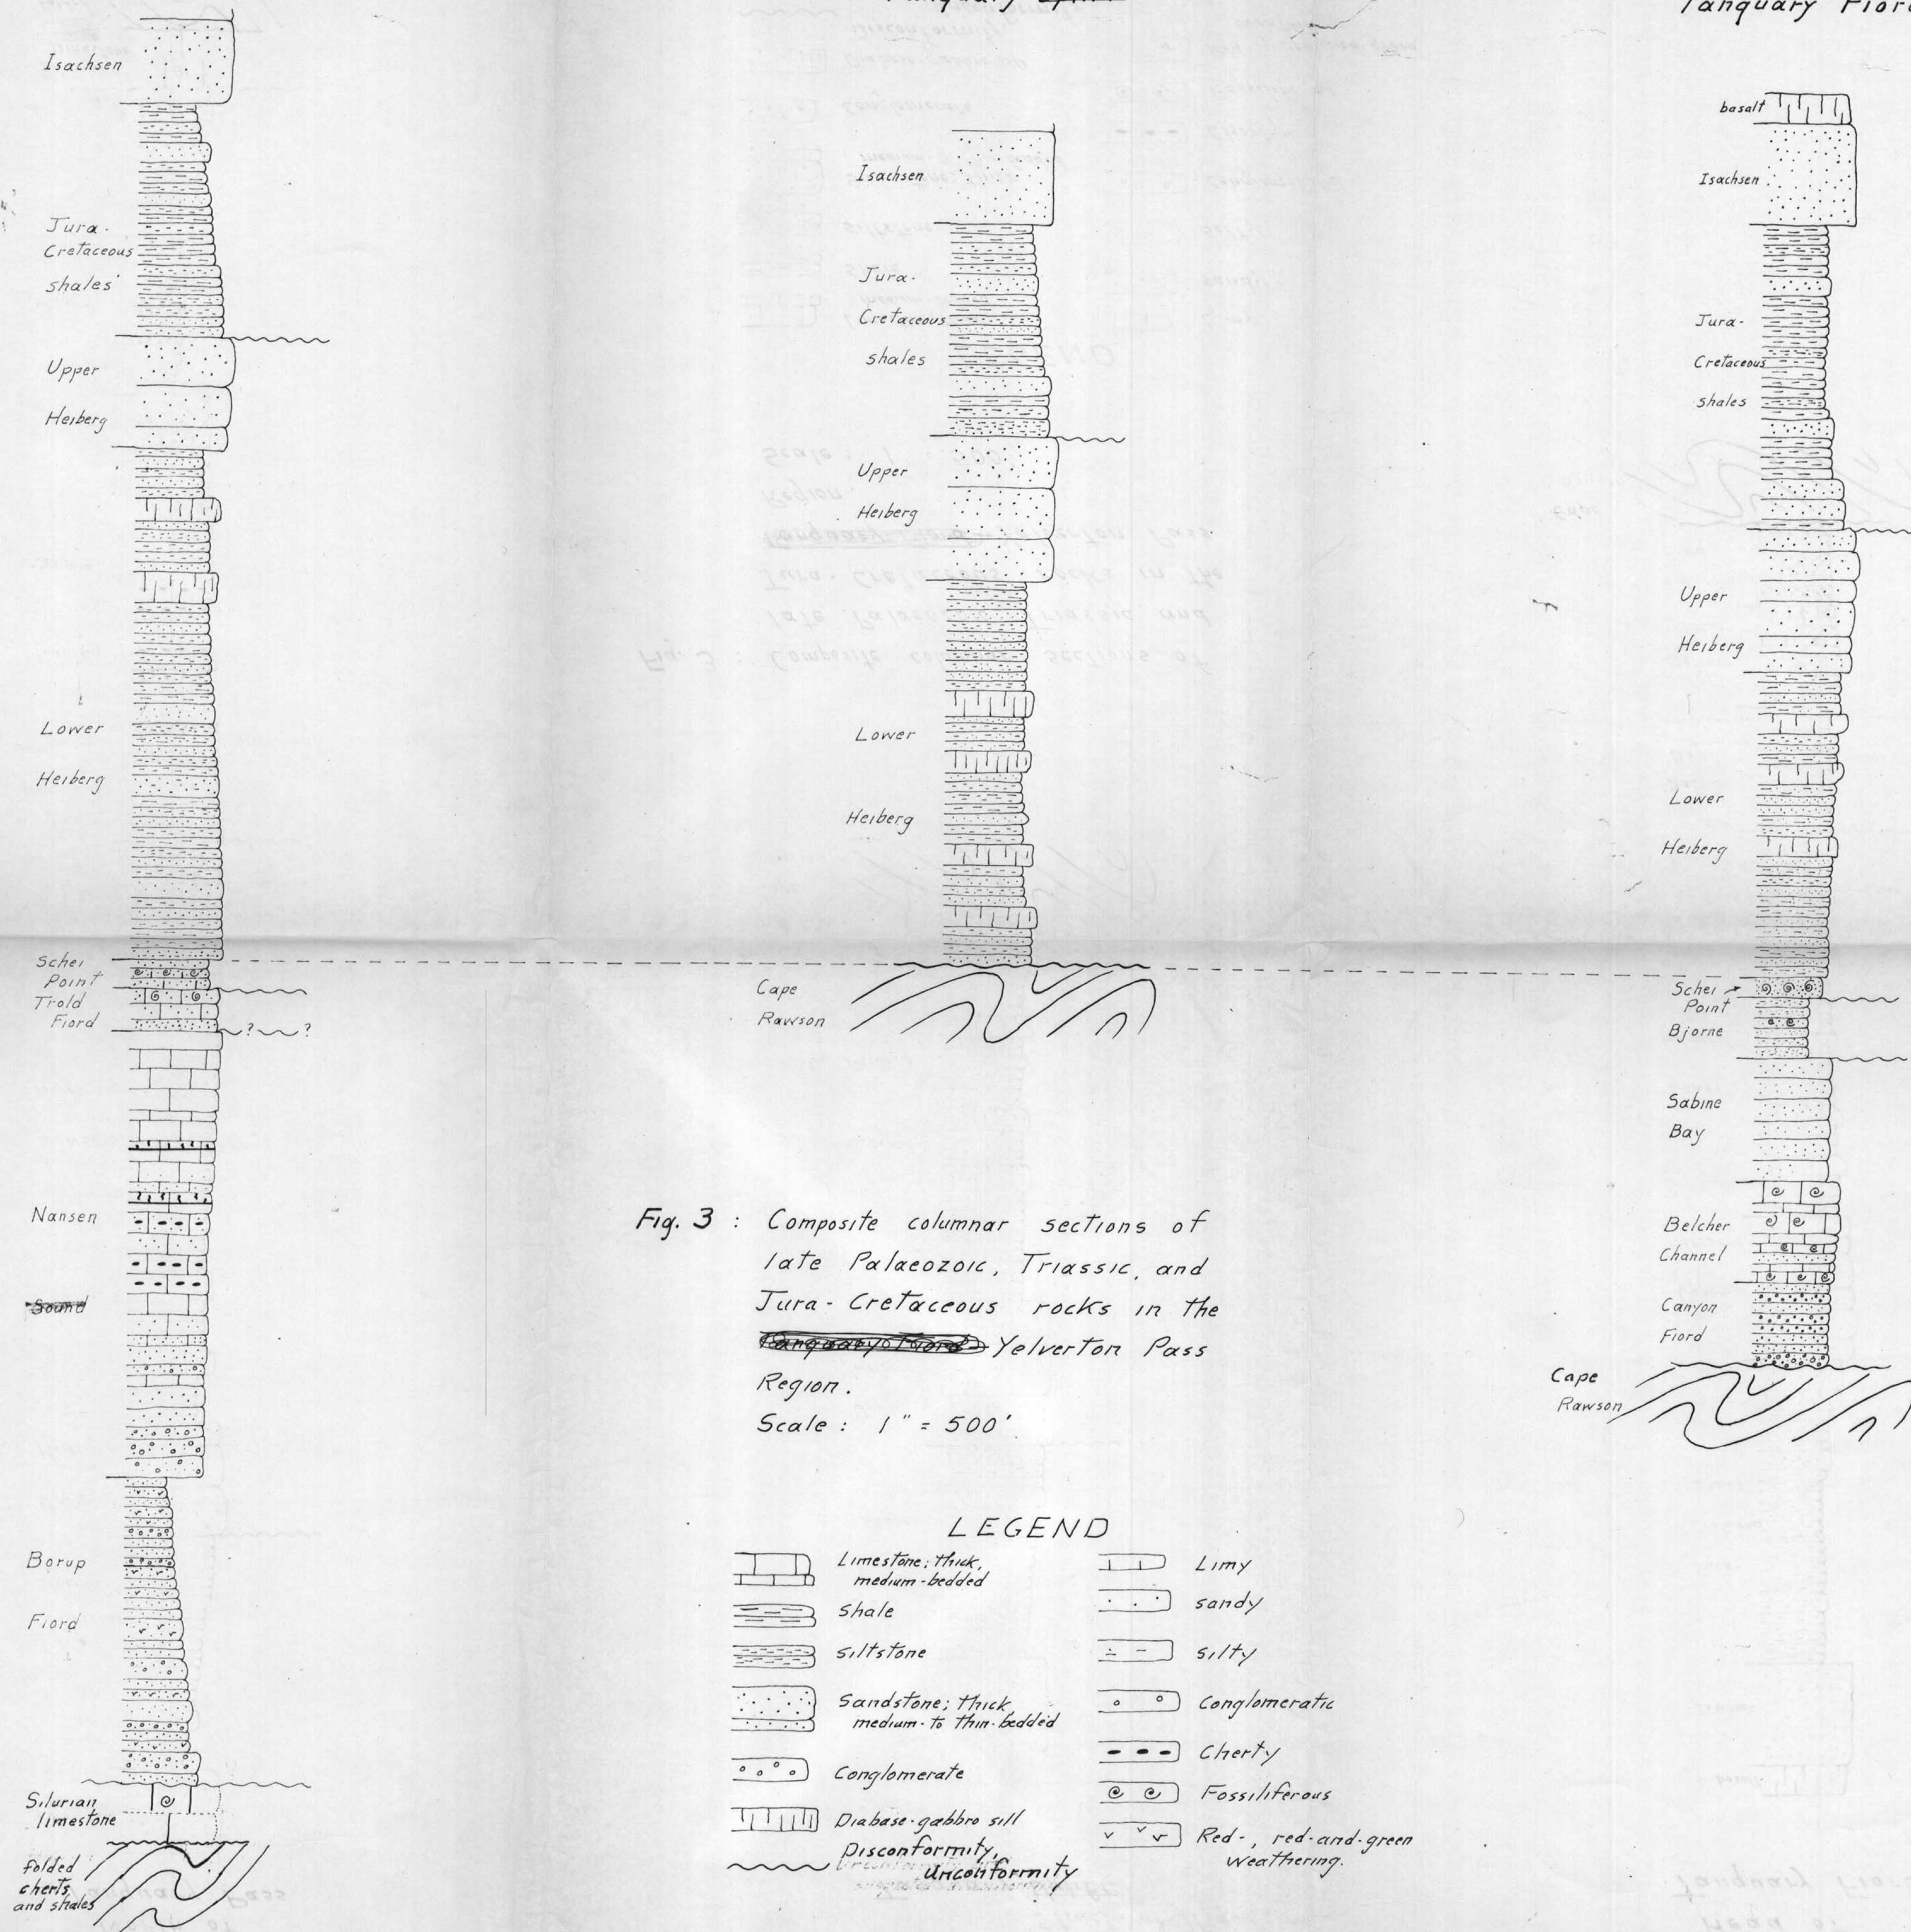


Fig. 3 : Composite columnar sections of late Palaeozoic, Triassic, and Jura-Cretaceous rocks in the ~~Tanquary Fiord~~ Yelverton Pass Region.
Scale : 1" = 500'

LEGEND

- | | | | |
|--|---|--|---------------------------------|
| | Limestone: thick, medium-bedded | | Limy |
| | Shale | | sandy |
| | siltstone | | silty |
| | Sandstone: thick, medium-to thin-bedded | | Conglomeratic |
| | Conglomerate | | Cherty |
| | Diabase-gabbro sill | | Fossiliferous |
| | Disconformity, unconformity | | Red-, red-and-green weathering. |