
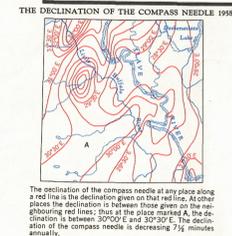


Ce document est le produit d'une numérisation par balayage de la publication originale.
This document was produced by scanning the original publication.

X TRAIL

Refer to this map as: 85A EDITION 1 MCE SERIES A 502 (1967)

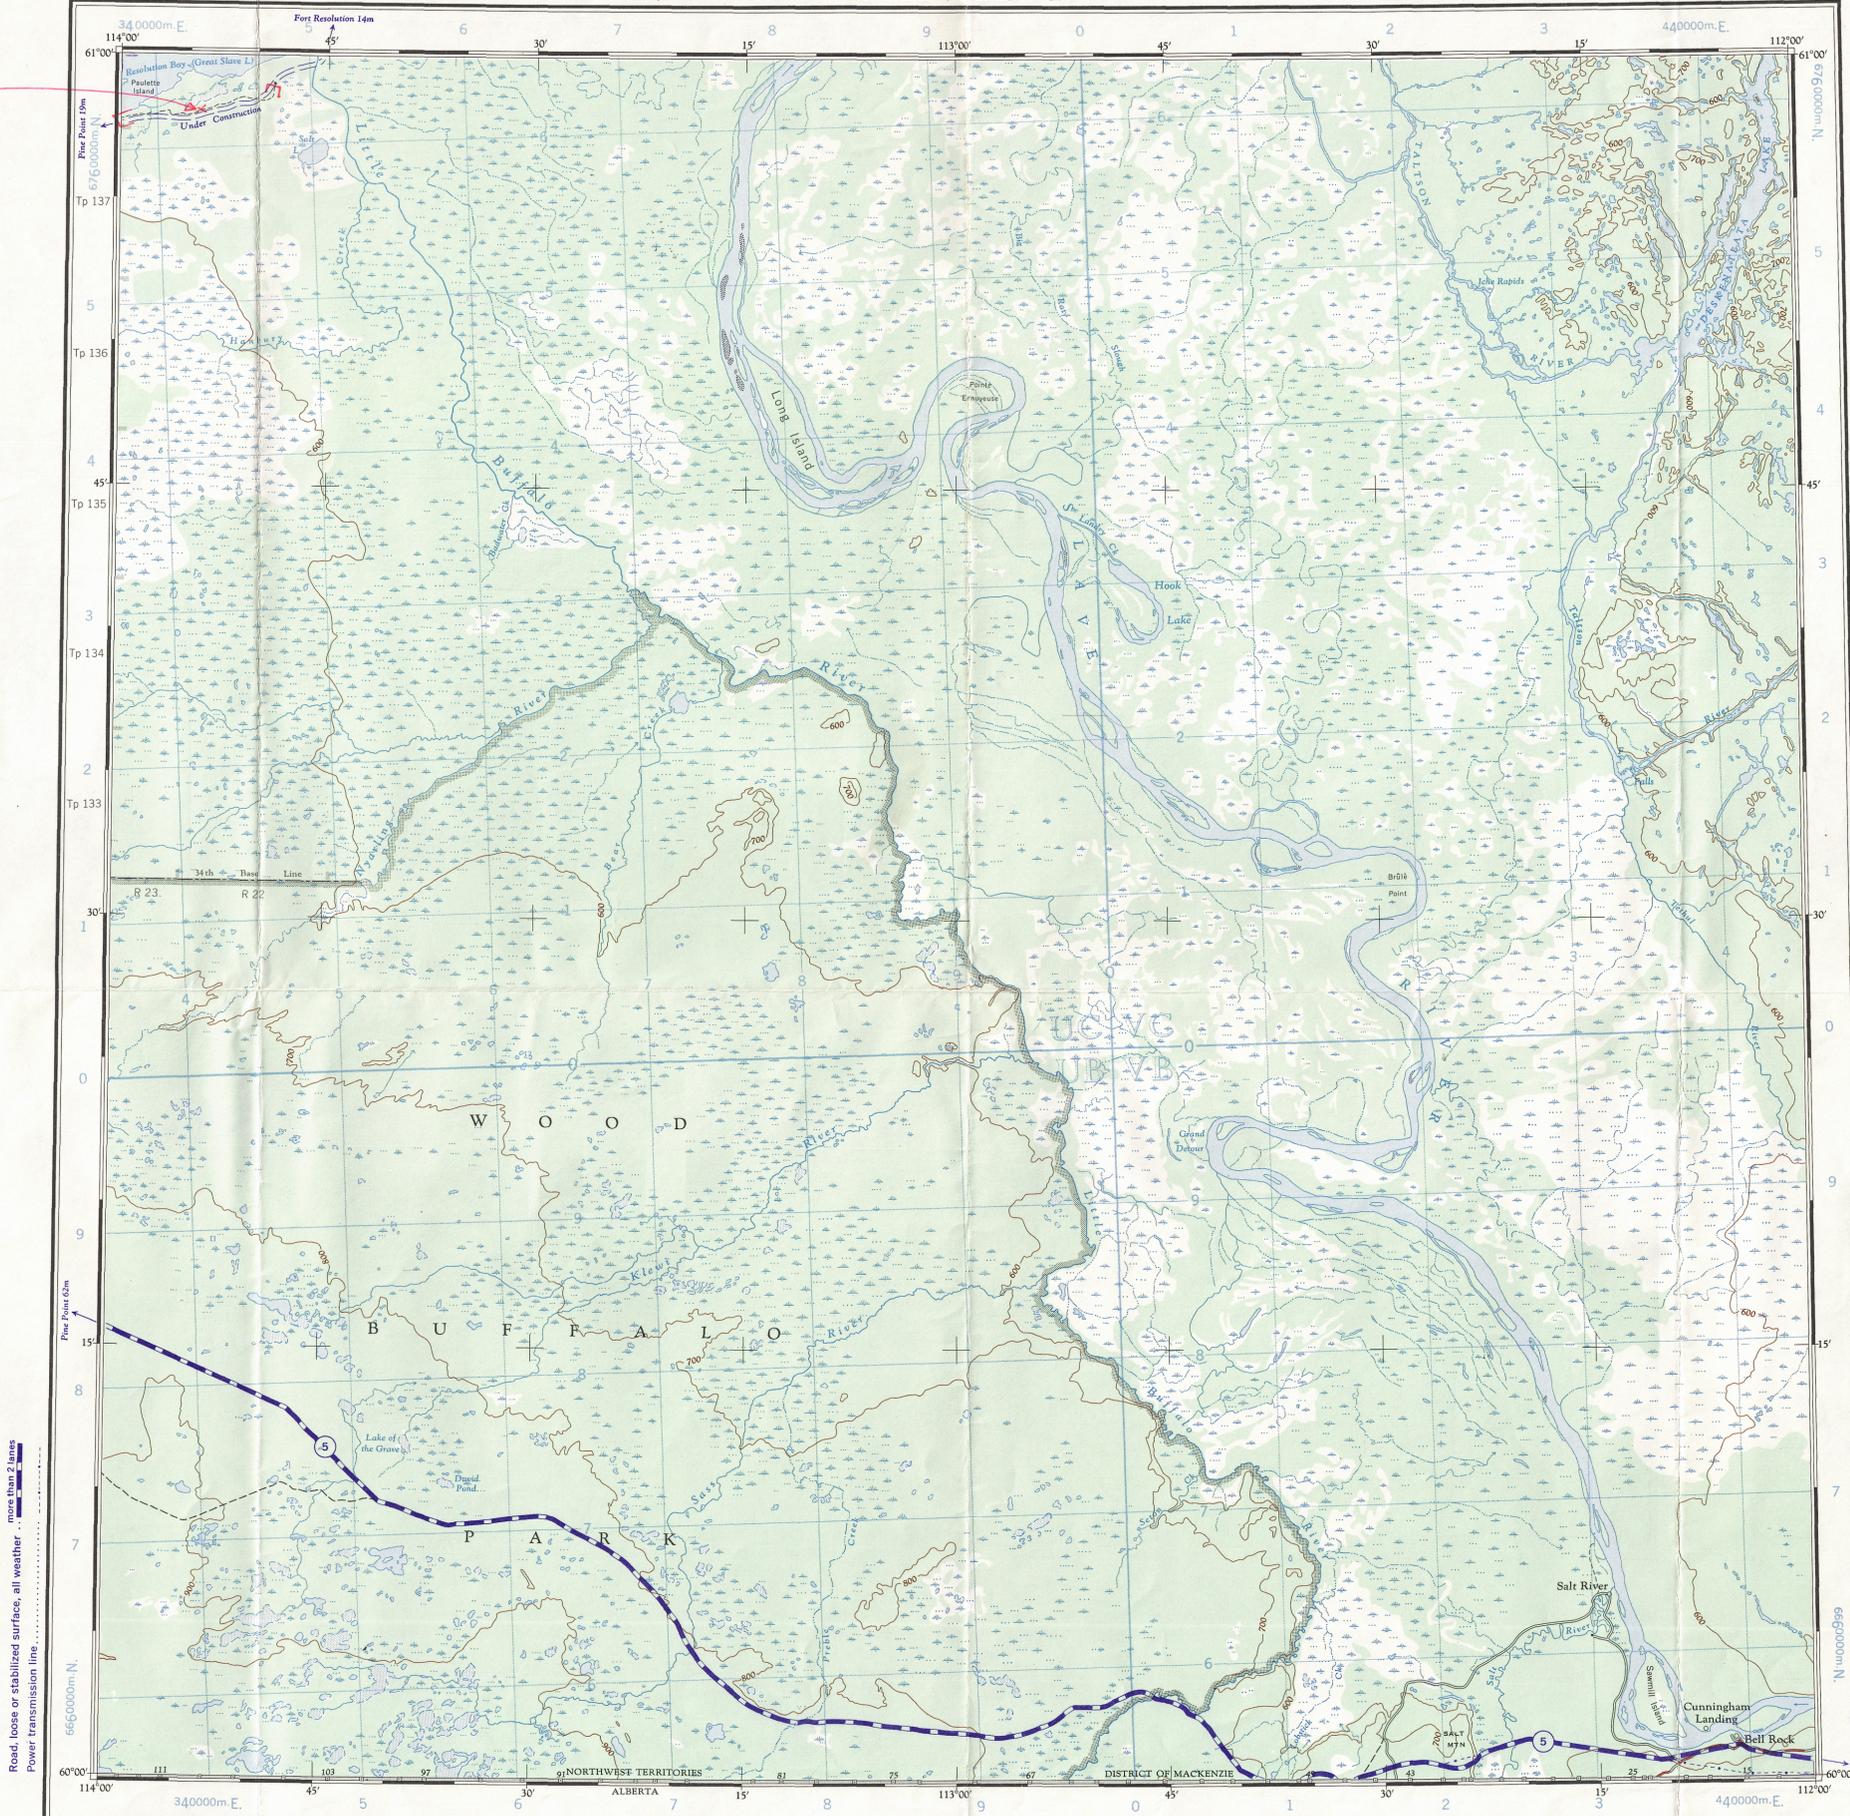

Produced and printed by the SURVEYS AND MAPPING BRANCH, DEPARTMENT OF MINES AND TECHNICAL SURVEYS, 1959, from air photographs taken in 1955.
Interim corrections 1967.

Symbol	Reference
Red line	Road, loose or stabilized surface, all weather
Blue line	Road, loose or stabilized surface, all weather
Black line	Wagon or cart track
Black dashed line	Trail or portage
Black solid line	Boundaries: provincial, Indian reserve, park, etc.
Black dashed line	Township, surveyed
Black dashed line	Township, unsurveyed
Red line	Contour: elevation
Red line	Contour: depression
Red line	Contour: approximate
Red line	Spot elevation (in feet)

LITTLE BUFFALO RIVER

NORTHWEST TERRITORIES
WEST OF FOURTH MERIDIAN

Scale 1:250,000
1 Inch to 4 Miles Approximately

Contour Interval 100 Feet
Elevations in Feet above Mean Sea Level
North American Datum 1927 (1985)

Miles 0 5 10 15 20 25 30
Kilometres 0 5 10 15 20 25 30

Symbol	Reference
Circle with dot	Village or settlement
Circle with cross	Boundary monument
Triangle	Horizontal control point
Blue line	Stream: intermittent or dry
Blue line	Stream: definite
Blue line	Irrigation canal or ditch
Blue line	Rapids; falls
Circle	Building or cabin
Circle with cross	School
Circle with cross	Church
Blue line	Intermittent lake
Blue line	Marsh or swamp
Blue line	Spice garden or meadow
Blue line	Forest

100,000 M. SQUARE IDENTIFICATION

GRID ZONE DESIGNATION: 12 V

TO GIVE A REFERENCE TO NEAREST 1000 METRES

EXAMPLE: LAKE

SQUARE: Read letters of 100,000 m. square immediately to left of point. Estimate tenths of a square from this line eastward to point.

NORTHING: Read number on grid line immediately below point. Estimate tenths of a square from this line northward to point.

MILITARY GRID REFERENCE (to nearest 1,000 metres): LC8832

If reporting beyond 10° in any direction, prefix Grid Zone Designation as: 12VUC8832

TEN THOUSAND METRE UNIVERSAL TRANSVERSE MERCATOR GRID ZONE 12

TOPOGRAPHICAL SURVEY DIRECTORATE
SERVICE TOPOGRAPHIQUE
DATE: 4-03-85
C.Q. APPROVES RELEASE
C.Q. APPROUVE

LITTLE BUFFALO RIVER
85A
EDITION 1 (1967)
REPRINT

NOTE FIT OF GREEN PAPER

85-A