


This document was produced by scanning the original publication.

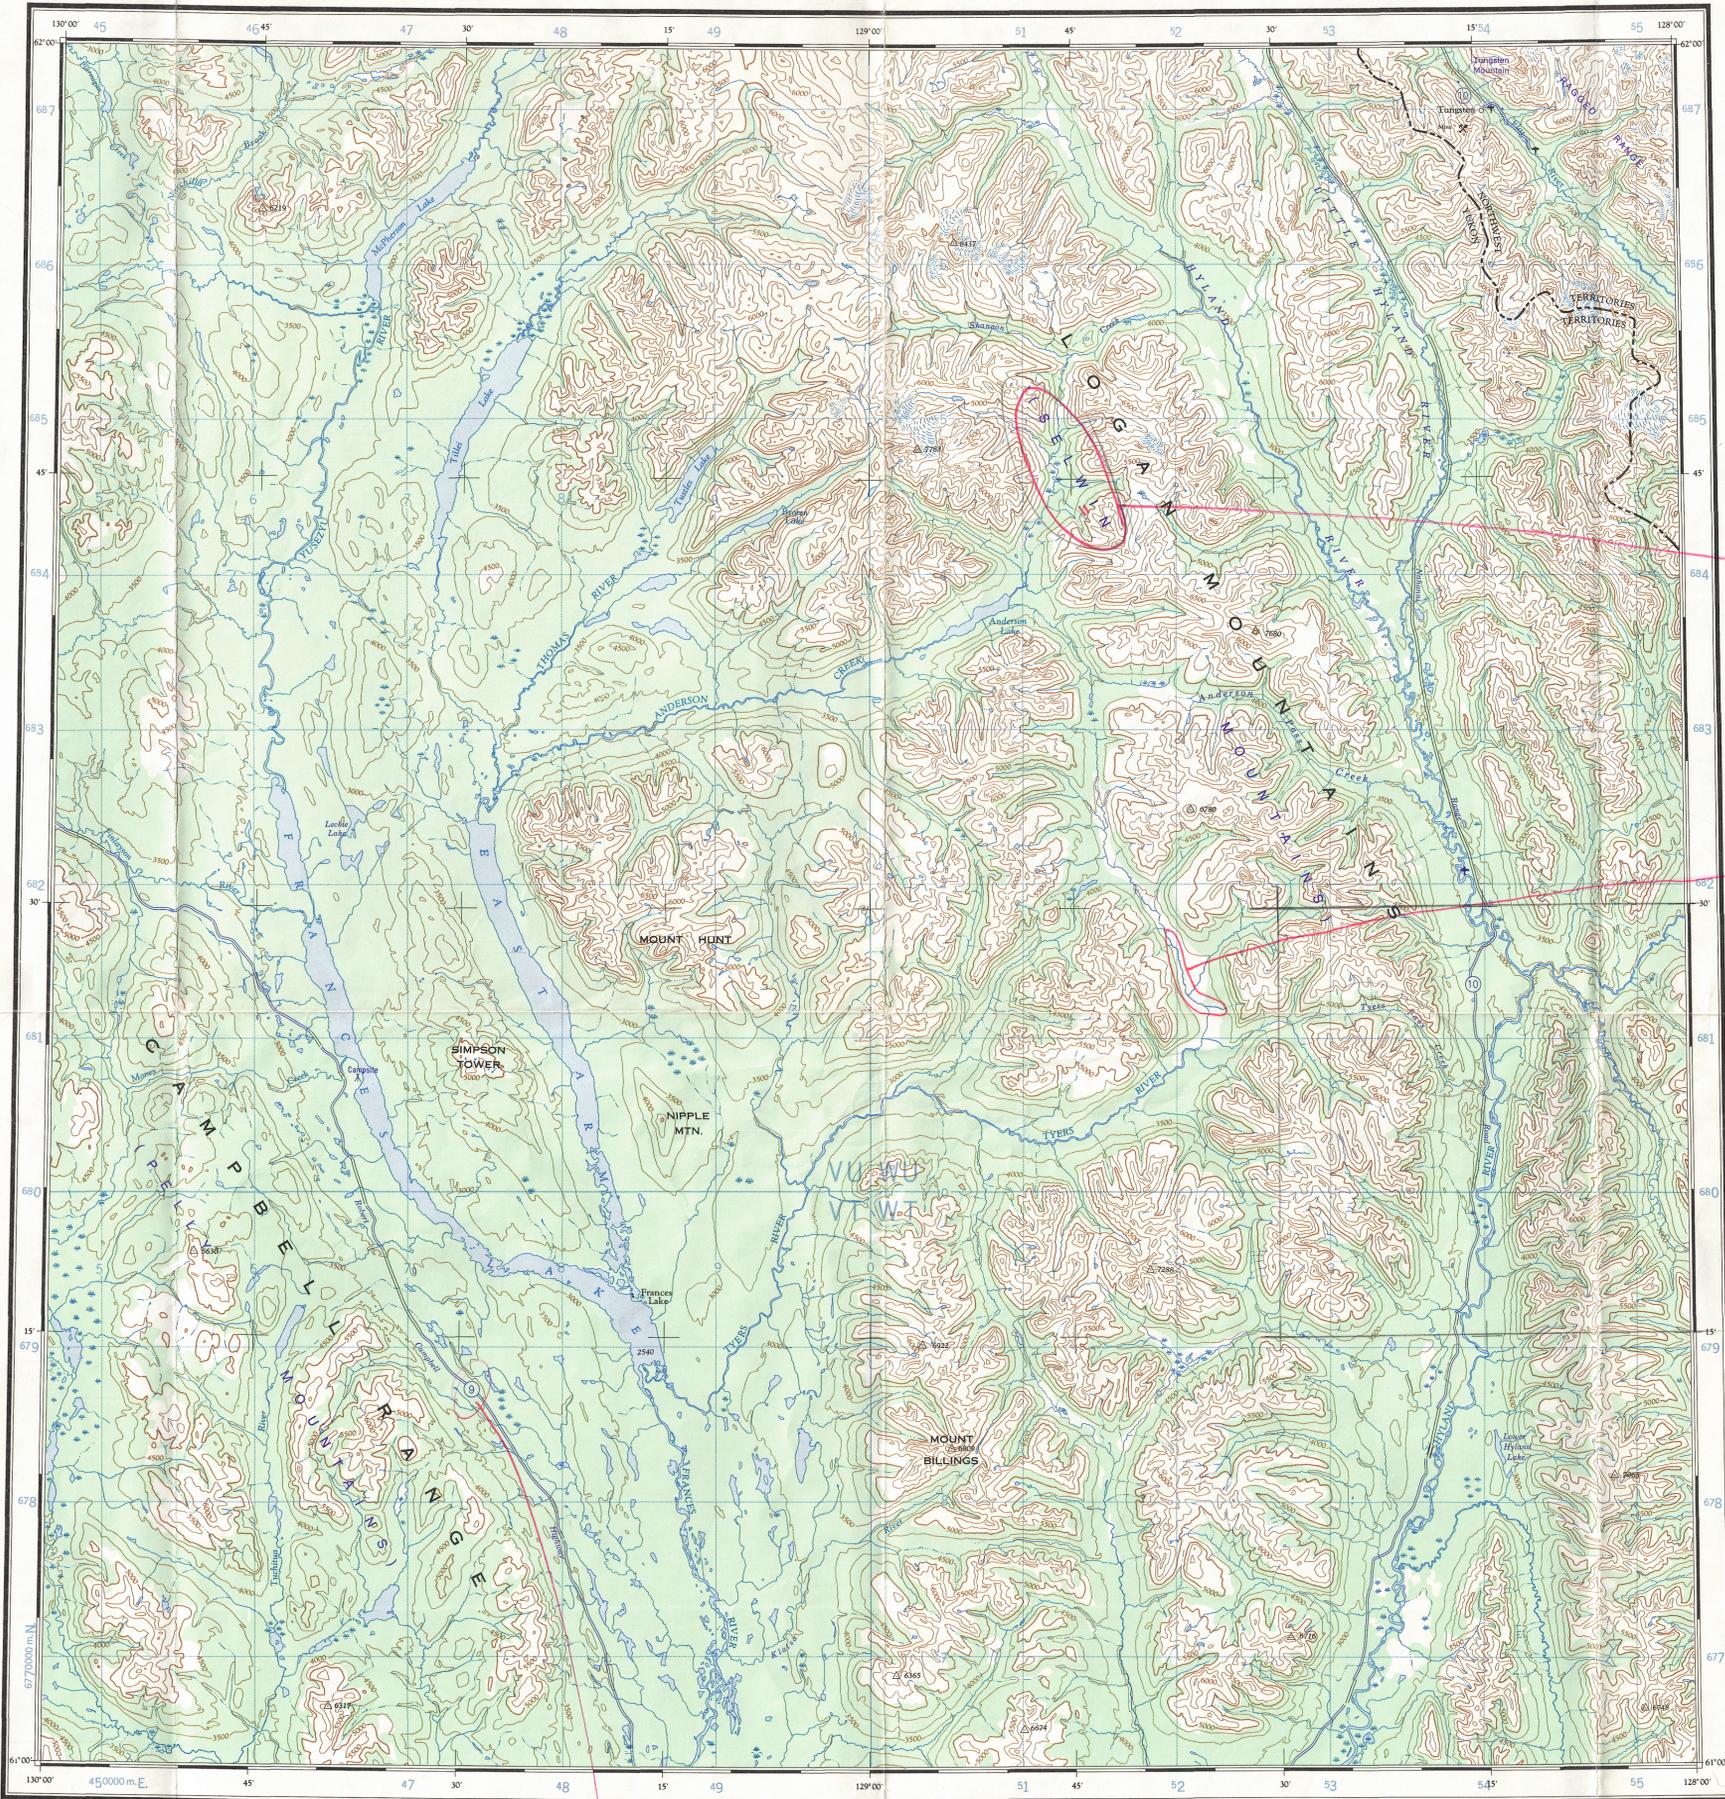

Military users, refer to this map as: **SERIES A502 SÉRIE MAP 105 H CARTE**  
Référence de la carte pour usage militaire: **EDITION 4 MCE ÉDITION**

226 776  
100  
40  
SELWYN?

AMR SELWYN MOUNTAINS  
16-05-85

X LT. BLUE

ANDRÉ

GRID ZONE DESIGNATION 2 V		TO ONE 4-DIGIT NUMBER ON THIS SHEET TO NEAREST 1000 METRES	
100,000 M. SQUARE IDENTIFICATION	SAMPLE POINT	TRIANGULATION STA.	WT
68Q	50	05	83
45 0000	NOTE: THE SMALLER figures of any grid number, those used for fixing the full coordinate, the ONLY the LARGEST figure of the grid number. example: 45 0000		WT0583 9VWT0583

TEN THOUSAND METRE  
UNIVERSAL TRANSVERSE MERCATOR GRID  
TOPOGRAPHICAL SURVEY DIRECTORATE  
SERVICE TOPOGRAPHIQUE  
DATE 21-2-84  
Q. C. APPROVES RELEASE  
C. Q. APPROUVE

THE DECLINATION OF THE COMPASS NEEDLE, 1951.  
The declination of the compass needle at any place along a red line is the declination given on that red line. At other places the declination is between those given on the neighbouring red lines, then at the place marked A, the declination is between N. 3° E. and N. 2° E. The accuracy of declinations of the compass needle are decreasing 2 minutes annually.

Surveyed, compiled, drawn and printed by the ARMY SURVEY ESTABLISHMENT R.C.E., 1949-51  
Aerial photography by R.C.A.F., 1949.  
Edition 3 revised 1966  
Transverse Mercator Projection.



Scale 1 : 250,000  
1 Inch to 4 Miles Approximately  
Interim Corrections 1974



REFERENCE

Road, Hard Surface, All Weather	More than 2 Lanes	Partially Completed
Road, Hard Surface, All Weather	2 Lanes	River No.
Road, Hard Surface, All Weather	Less than 2 Lanes	2 Lanes
Road, Loose Surface, All Weather	More than 2 Lanes	1 Lane
Road, Loose Surface, All Weather	2 Lanes	2 Lanes
Road, Loose Surface, Less than 2 Lanes	All Weather	Dry Weather
Road, Single Track		
Boundary, International		
Boundary, Province or State		
Boundary, County or District		
Boundary, Township, Indian, Military, Park, etc.		

ROADS-ROUTES:  
hard surface - pavé  
loose surface - de gravier  
cart track - de terre  
trail - sentier  
Deletions - Suppressions

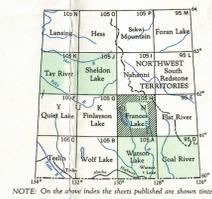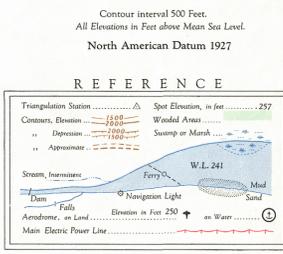

FRANCES LAKE  
YUKON TERR.—NORTHWEST TERR.  
SHEET 105H  
EDITION 4  
REPRINT

105-H